AUTHORITY	DATE INSTALLED OR RETIRED		DESCRIPTION
C-21263 A.F.E. 2363	Installed	July 14, 1923	Construction of Track 124.E, total 1,320' for the Standard Oil Co. P.S. in main track at sta. 1250+39.4, B.&O.R.R. to own from P.S. to Cl. Pt. 123. Also installation of 36' of 12" V.C.P. under railroad portion.
C-27783 A.F.E. 10586	Completed	June 26, 1923	Wood T.O. signal and 12'x16' frame tower formerly on right of sta. 1217+25.5 destroyed by fire. Replaced by 12'x14' fr. tower and wood T.O. signal on right of sta. 1217+23.0, moved to this location from right of sta. 1309+20, Lake No. 5, Y.& H.R.R. Retired from that location under A.F.E. 10524. See also C-22563, below.
C-23363 A.F.E. 702	Installed	May 23, 1925	Installation of iron T.O. signal on right of sta. 1217+25.8 and retirement of old wood T.O. signal formerly on right of sta. 1217+33.1. Wood signal was installed under 340 C-27783, above.
C-28724 A.F.E. 2656	Completed	May 8, 1926	Replacement of bridge No. 325, timber trestle, with 8' Doll Top Culvert. East abutment at sta. 1172+21.0.
C-28886 A.F.E. 11404	Retired	May 10, 1927.	Retirement of Stock Pens, Sta. 1254+00.
C-29600 A.F.E. 11934	Completed	Aug. 2, 1926.	Crossover & additional team track Sta. 1254+00.5 to Sta. 1247+09.2.
C-29340 A.F.E. 11760	Installed	Oct. 20, 1926.	Sidewalk at Spring St. Station 1250+41.5.

CONTINUED ON REVERSE SIDE.

PARCEL No.	CUSTODIANS No.	KIND OF INSTRUMENT	DATE OF INSTRUMENT	GRANTOR	GRANTEE	RECORDED BOOK	RECORDED PAGE	RECORDED DATE	AREA ACRES	AREA SQUARE FEET	114-C Map 12 REMARKS
1											Same as Parcel No. 23, Map No. 11.
2	251	War. Deed	Oct. 27 1874	Phillip Moon, et ux.	PATHR	77	20	Jan 19 1875	4.695		1750 sq.ft. occupied by Public Road.
3	252	Q.C. Deed	Apr. 2 1873	Chester Gabb, et ux	PATHR	77	22	Jun 12 1875	1.513		For easement for highway purposes, see Cust. No. 841.
4	253	Q.C. Deed	Oct. 28 1874	R.B. Thompson Admr. of Estate of Jacob Gates.	PATHR	77	23	Jun 21 1875	4.674		For easement for highway purposes, see Cust. No. 841.
5	254	War. Deed	Apr. 3 1873	Joseph L. White, et ux.	PATHR	77	25	Jun 22 1875		32200	
6	255			Levi Morse, et ux.	PATHR				1.056		Deed prepared but not executed.
7	256	War. Deed	Apr. 1 1873	John R. Stone, et ux.	PATHR	77	47	Jan. 11 1882	3.372		
8	257	War. Deed	Apr. 2 1873	William F. Nichols	PATHR	79	294	Sept 8 1877	1.954		
		Q.C. Deed	Apr. 2 1873	William F. Nichols, et ux.	PATHR						
9	258	Q.C. Deed	Apr. 2 1873	J.J. Atwood, et ux.	PATHR	77	49	Jan 11 1875	1.926		
10	259	War. Deed	Aug. 24 1897	Williams S. Thompson.	PATHR	105	129	Aug. 24 1897	4.723		Cust. Area = 4.723 Ac. Same as Parcel No. 1, Map No. 13. 6000 sq.ft. occupied by Main St. Retired. Another See Cust. No. 259 map 13, A.F.E. 40248. Joint ownership in a 4" Sewer on property of Murnaw. See License No. 42791, A.F.E. 45173.
11		Agreement	Jan. 1 1959	George H. Murnaw	B.&O.R.R.						

GEAUGA COUNTY, OHIO
MIDDLEFIELD TWP.
T-7-N R-6-W

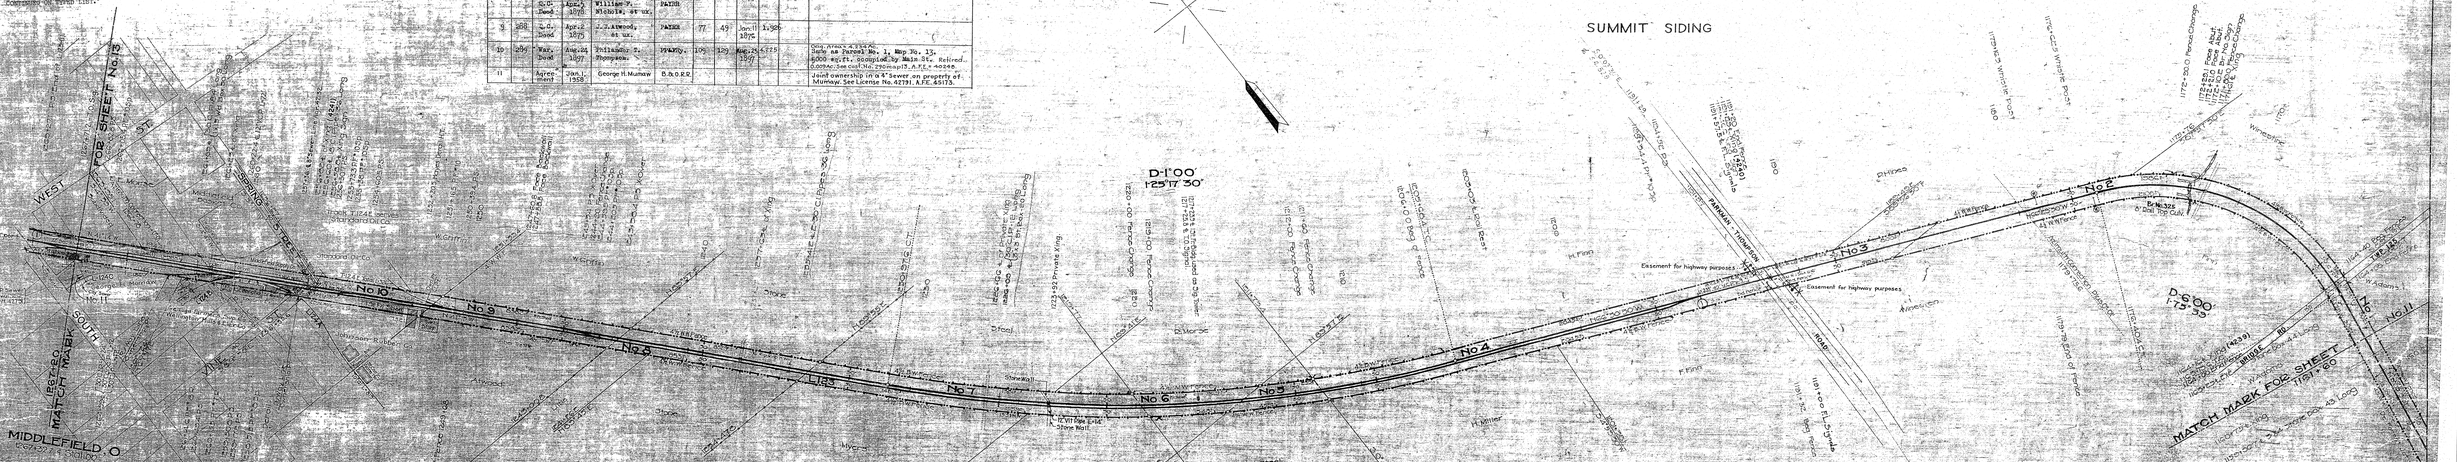
SUMMIT SIDING
D-1°00'
1°25'17" 30"
D-6°00'
7°5'39"
No 2
No 3
No 4
No 5
No 6
No 7
No 8
No 9
No 10
No 11
WEST
SPRING
ST
SOUTH
GROVE ST
MIDDLEFIELD O
MATCH MARK FOR SHEET No. 13
MATCH MARK FOR SHEET 17+97.60
Easement for highway purposes
Easement for highway purposes
PARKMAN - THOMPSON ROAD
Wheelock
Atwood
H. Miller
Stone
Stone Hall
Steel
Steel
Steel